


CEDAR RIDGE SOLAR + STORAGE

SINGLE-LINE DIAGRAM · AES INDIANA INTERCONNECTION EXHIBIT

120 MWAC Solar + BESS | MISO DPP | TO: AES Indiana | County: Marion, IN | Rev: A | Date: ____

GRIDPILOT DEMO DRAWING

AES Indiana Facilities Connection gaps

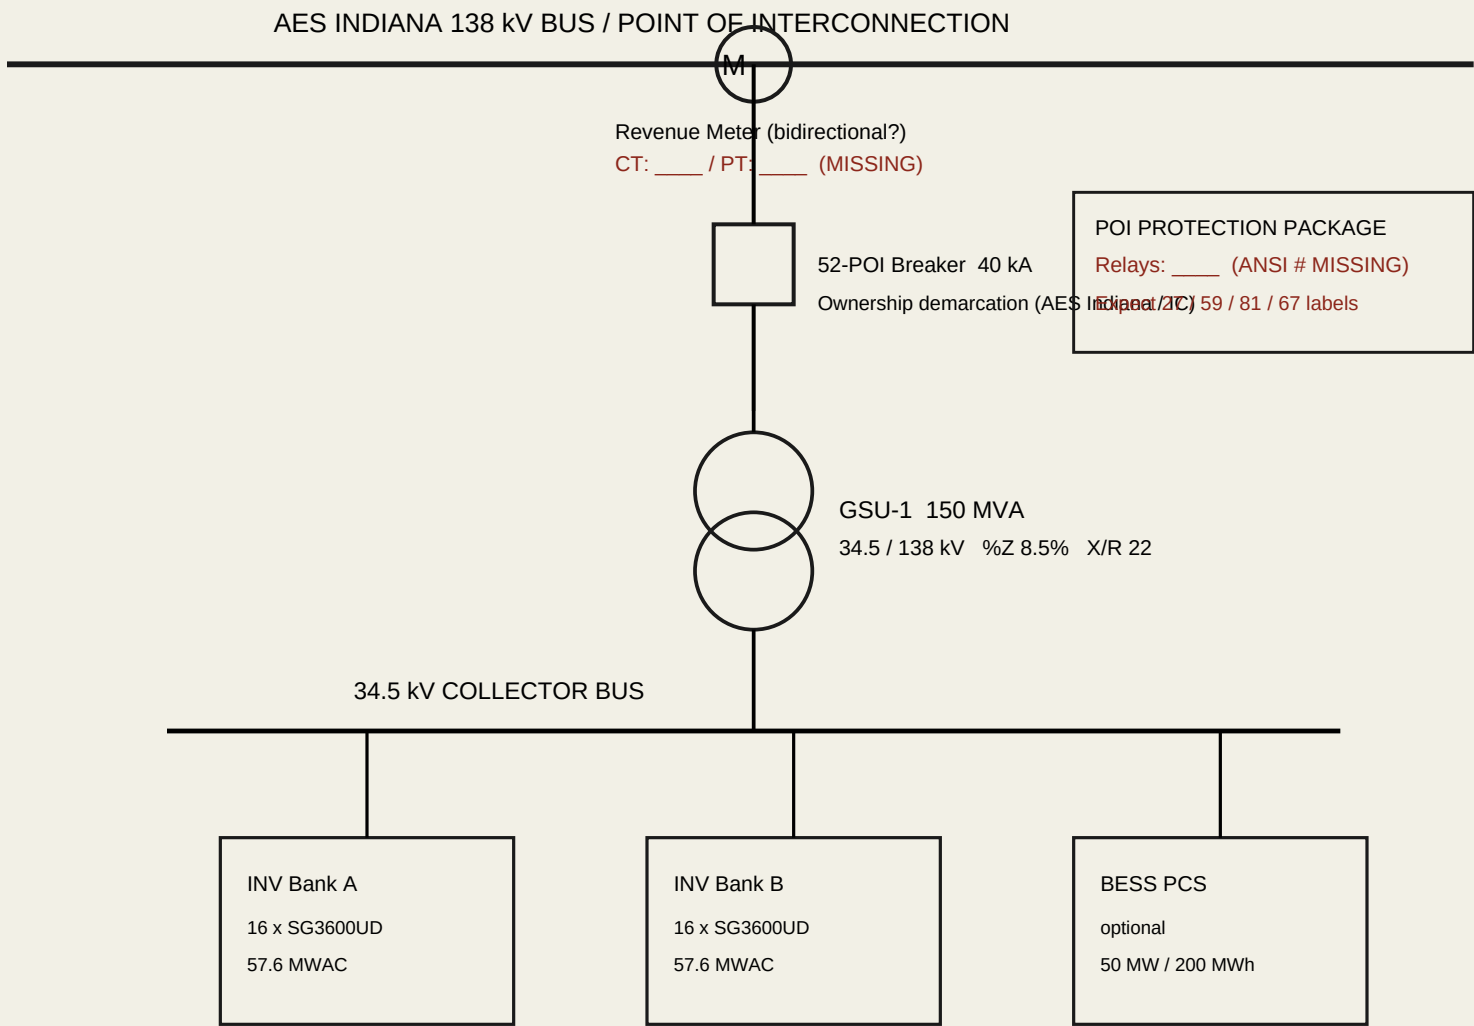

NOTES (AES Indiana / MISO demo):

1. R-POI-01 OK: AES Indiana 138 kV POI + ownership at 52-POI shown.
2. R-PROTECT-01 GAP: Relay ANSI function numbers not labeled.
3. R-METER-01 GAP: CT/PT ratios blank at revenue meter.
4. R-IBR-01 GAP: P-Q / capability curves, PFR droop, VAR-002 AVC not shown.
5. R-TITLE-01 GAP: As-built date blank · AES Indiana requires as-built one-lines before energization.
6. Filing path: MISO DPP queue + AES Indiana PowerClerk (aesindianainterconnection.powerclerk.com).